


**Labor and Materials**

.....Copper } Connection.....	$\frac{1}{2}$	96	
.....Curb { Cock Valve } .....in.....	$\frac{3}{4}$	1.38	
.....Service Box { <del>Sheet 4 1/2 x 5 1/2</del> } .....in.....		1.35	
.....Old returned { Long 4 1/2 x 5 1/2 } .....in.....			
..... <del>4</del> Ft. 3 1/4 in. { Copper Galv. Iron } Pipe at 1.5.....	1.5	3.5	
.....Nipples .....in. at.....			
.....Bushings .....to.....in. at.....			
.....Red'g Inc'g } Couplings.....to.....in. at.....			
.....Union.....in. at.....			
.....Meter.....in. at.....			
.....Lbs. Br. Stone at.....			
.....Lbs. Sand at.....			
.....Bags Cement at.....			
.....Paving Brick { Mack Red Asphalt } at.....			
.....Lead Joints at.....			
.....Leadite Joints at.....			
.....Hrs. Foreman at.....			
.....Hrs. Common Labor at.....			
.....Hrs. Common Labor at.....			
.....Hrs. Mason at.....			
.....Hrs. Masons Helper at.....			
.....Hrs. Compressor at.....			
.....Compensation Ins.....			
.....Trucking.....			
.....Builders Use of Water Patch.....		5-	
Total \$.....			

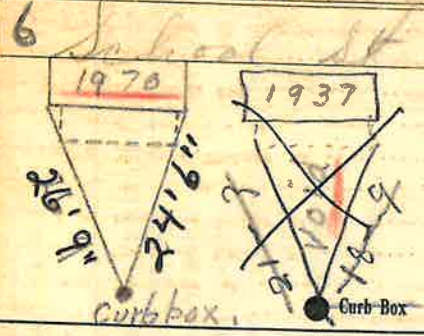

6" C.I. - 1970  
Main Elev of Main at tap 5  
Gate at ● Gate at ●

● Curb Box  
old shut off at main  
Shut off at Curb Box  
9-18-74  
4' to main  
3/4" COPPER