

LABOR AND MATERIALS

1	Copper Lead	} Connection	3/4		\$ 1.79
1	Curb	{ Clock Valve T.S. & V. }	3/4	in.	\$ 2.61
1	Service box Old returned	{ Short 3 1/2 X 4 1/2 Long 4 1/2 X 5 1/2 Buff or Rdway			\$ 1.82
8	Ft. 3/4	in. { Copper Galv. Iron Cast Iron		Pipe at 23	\$ 1.38
	Nipples	in. at			\$
	Bushings	to in. at			\$
	Red'g Inc'g	Couplings	to	in. at	\$
	Union	in. at			\$
	Meter	in. at			\$
	Lead Joints at				\$
	Compound Joints at				\$
	Hrs. Foreman at				\$
6	Hrs. Chauffeur at	8.2 1/2			\$ 4.95
	Hrs. Tapper at				\$
10	Hrs. Labor at	7.1 1/2			\$ 7.15
	Hrs. Labor at				\$
	Hrs. Compressor at				\$
	Compensation Ins.				\$ 3.3
	Trucking				\$ 1.00
	Builders Use of Water				\$
	Tap by W.A.S.M.S. Co.				\$
	This tap is on 6" lateral				\$
					\$
					\$
					\$ 21.03


23 1/2

School

St.
 Pl.
 Ave. No. 10

Name of Owner
 Turner

Labor and Mat'l. Report Aug 28 1946

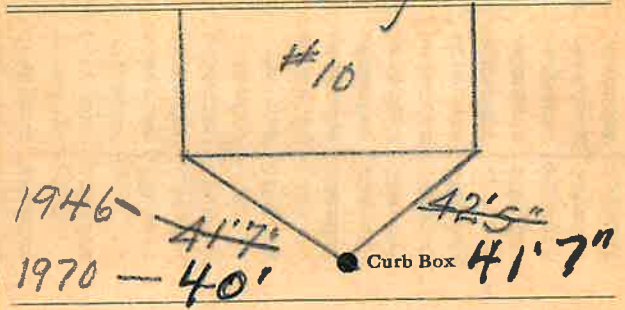

6" Main Elev. of Main at tap 5'

Gate at ● Gate at ●

TAX ID # 309.28-6-2

● Curb Box
Remeasured
5-26-70
8' to main Donovan & Co.
3/4" Copper