

### LABOR AND MATERIALS


1	Copper Lead } Connection $\frac{3}{4}$		\$ 1.80
1	Curb } Curb Valve } T. S. & V. } $\frac{3}{4}$ in.		\$ 1.96
1	Service Box Old returned	{ Short $3\frac{1}{2} \times 4\frac{1}{2}$ Long $4\frac{1}{2} \times 5\frac{1}{2}$ Buffer Rdway }	\$ 1.82
19	Ft. $\frac{3}{4}$ in.		
		{ Copper Galv Iron Cast Iron }	Pipe at \$ 3.61
	Nipples	in. at	\$
	Bushings	to in. at	\$
	Red'g Inc'g	Couplings to in. at	\$
	Union	in. at	\$
	Meter	in. at	\$
	Lead Joints at		\$ 1.00
	Leadite Joints at		\$
	Hrs. Foreman at		\$ 1.00
10	Hrs. Chauffeur at	68 $\frac{3}{4}$	\$ 6.98
	Hrs. Tapper at		\$
6	Hrs. Labor at	.60	\$ 3.60
	Hrs. Labor at		\$
	Hrs. Compressor at		\$
	Compensation Ins.	2.669	\$ 2.8
	Trucking		\$ 1.00
	Builders Use of Water	D.P.	\$
	1 days by Miller		\$
			\$
			\$
			\$ 20.95

13-144

St. School  
Pt.   
Ave. No. 12

Name of Owner Kalkfleisch

Labor and Mat'l. Report June 9 1948

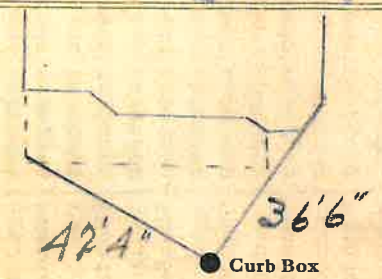

4 Gal Main Elev. of Main at tap 7"

Gate at • Gate at •

TAX ID # 309.28-6-3

19' to main • Curb Box  
3/4" COPPER

To be Billed ✓