

LABOR AND MATERIALS

1	Copper Lead	{ Connection	3/4"	\$
1	Curb	{ Cock Valve T.S. & V.	3/4" in.	\$
1	Service box Old returned	{ Short 3 1/2 x 4 1/2 Long 4 1/2 x 5 1/2 Buff or Rdway		\$
12 Ft.	3/4 in.	{ Copper G.I. C.I.	Pipe at	\$
	Nipples	in. at		\$
	Bushings	to in. at		\$
	Red'g Inc'g	{ Coupl'gs to in. at		\$
	Union	in. at		\$
	Meter	in. at		\$
	Lead Joints at			\$
	Compound Joints at			\$
	Maintenance Foreman			\$
	Hrs. Water Maint. Man-1 at			\$
	Hrs. Water Maint. Man-2 at			\$
	Hrs. Garage Foreman at			\$
	Hrs. Labor at			\$
	Hrs. Compressor at			\$
	Compensation Ins. at \$	per C		\$
	Trucking			\$
	Pav't Patch			\$
	Tap by Hermance + Co	March 29, 1977		\$
	O'head			\$


St. Pl. Ave. No. 15

School

Name of Owner

Richard Frazier

Labor and Mat'l Report March 29, 1977

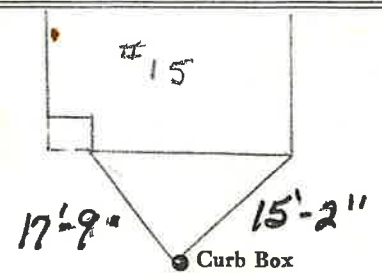

4" Main

Elev. of Main at tap

Gate at ●

● Gate at

● Curb Box

12' to main
3/4" copper