


Labor and Materials

| | | | | | |
|------------------------|-----------------|--------------|---------|----|-------|
| Copper | Lead | Connection | 3 | \$ | 3.20 |
| Curb | Cock Valve | F.S. & V. | 13 | \$ | 1.00 |
| Service Box | Short 3/4 x 1/2 | Old returned | 4 | \$ | 1.30 |
| 9 Ft. | Copper | Cast Iron | 3 | \$ | 1.98 |
| Nipples | | | VI | \$ | |
| Bushings | | | | \$ | |
| Red'g | Inc'g | Couplings | | \$ | |
| Union | | | | \$ | |
| Meter | | | | \$ | |
| Lbs. Br. Stone | | | | \$ | |
| Lbs. Sand | | | | \$ | |
| Bags Cement | | | | \$ | |
| Paving Brick | Mack | Red | Asphalt | | |
| Lead Joints | | | | \$ | |
| Leadite Joints | | | | \$ | |
| 3 Hrs. | Foreman | | | \$ | 1.58 |
| 2 Hrs. | Common Labor | | | \$ | 1.00 |
| 16 Hrs. | Common Labor | | | \$ | 6.50 |
| Hrs | Mason | | | \$ | |
| Hrs | Mason's Helper | | | \$ | |
| Hrs. | Compressor | | | \$ | |
| Compensation | Ins | | | \$ | 2.50 |
| Trucking | | | | \$ | 1.00 |
| Builders' Use of Water | | | | \$ | |
| Total \$ | | | | | 18.11 |

Labor and Material Report Aug 17 1928

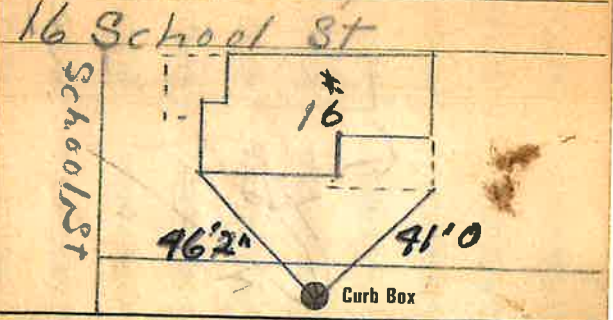

10" Main
 Elev of Main at tap 4 1/2
 Gate at ● TAX ID # 309.28-6-5 ● Gate at

● Curb Box
 Old tap shut off
 9' to MAIN
 3/4" COPPER
 This curb Box was set Bar 12 Aug 22-49