


Labor and Materials

Copper	Connection		\$ 2.60
Curb	Cock Valve	in.	\$ 2.30
Service Box	Short 3 1/2 x 1 1/2		\$ 1.40
Old returned	Long 4 1/2 x 1 1/2		
	Buff. or Rdway		
10 Ft.	Copper Galv. Iron	Pipe at 3/4	\$ 2.65
	Nipples	in. at.	\$
1	Bushings	1/2 to 3/4 in. at.	\$.10
	Red'g Inc'g	Couplings to in. at.	\$
	Union	in. at.	\$
	Meter	in. at.	\$
	Lbs. Br. Stone	at.	\$
	Lbs. Sand	at.	\$
	Bags Cement	at.	\$
	Paving Brick	Mack Red Asphalt at.	\$
	Lead Joints	at.	\$
	Leadite Joints	at.	\$
3	Hrs. Foreman	at.	\$ 1.88
12	Hrs. Common Labor	at.	\$ 4.88
	Hrs. Common Labor	at.	\$
	Hrs. Mason	at.	\$
	Hrs. Mason's Helper	at.	\$
	Hrs. Compressor	at.	\$
	Compensation Ins.		\$.18
	Trucking		\$ 1.00
	Builders' Use of Water	Patch	\$ 5.00
Total			\$ 21.99

29-134

Labor and Material Report August 17 1929

17 Sub-station

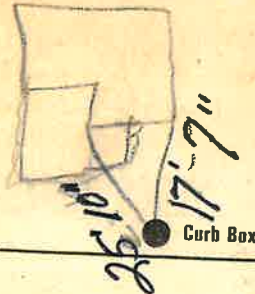

4 Main Eley of Main at tap 4 1/2

Gate at TAX ID # 309.28-2-12 Gate at

● Curb Box

Old by disconnected
10' to main
3/4" COPPER