

Labor and Materials


Copper } Connection.....	3/4	\$ 1.50
Lead }	1/2	
Curb { Cock Valve }	3/4	\$ 1.70
{ N.S.&V. }	3/4	
Service Box { Sheet 2 1/2 x 4 1/2 }		\$ 1.54
Old returned { Long 4 1/2 x 5 1/2 }		
{ Bolt or Nut }		
22 Ft. } in. { Copper } Pipe at		\$ 4.18
{ Galv. Iron }		
{ Cast Iron }		
Nipples	in. at	\$
Bushings	to	\$
{ Red'g }	in. at	\$
{ Inc'g }	to	\$
{ Couplings }	in. at	\$
Union	in. at	\$
Meter	in. at	\$
Lbs. Br. Stone at		\$
Lbs. Sand at		\$
Bags Cement at		\$
Paving Brick { Mack } at		\$
{ Red }		
{ Asphalt }		
Lead Joints at		\$
Leadite Joints at		\$
3 Hrs. Foreman at	6 1/2	\$ 1.89
5 Hrs. Common Labor at	50	\$ 3.-
6 Hrs. Common Labor at	45	\$ 7.70
Hrs. Mason at		\$
Hrs. Masons Helper at		\$
Hrs. Compressor at		\$
Compensation Ins		\$ 0.24
Trucking		\$ 1.-
Builders Use of Water <i>Power Patch</i>		\$ 5.-
Total \$		22.74

12 34

Labor and Material Report

May 3 1934

14 Second St

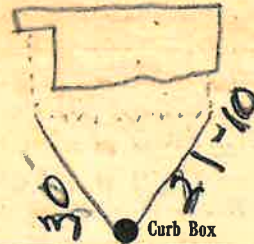

6" Main

Elev. of Main at tap 5'

Gate at TAX ID # 309.12-10-12 Gate at

● Curb Box

old Tap shut off at Main

22' to main

3/4" copper

[Handwritten signature]

1/24