

LABOR AND MATERIALS

1	Copper Lead	Connection	3/4"	\$	308
1	Curb	Cock Valve F.S. & V.	3/4 in.	\$	389
1	Service box Old returned	Short 3 1/2 x 4 1/2 Long 4 1/2 x 5 1/2 Buff or Rdway		\$	432
12	Ft. 3/4 in.	Copper G.I. G.I. } Pipe at	45	\$	5.40
	Nipples	in. at		\$	
	Bushings	to in. at		\$	
	Red'g Inc'g } Coupl'gs	to in. at		\$	
	Union	in. at		\$	
	Meter	in. at		\$	
	Lead Joints	at		\$	
	Compound Joints	at		\$	
	Maintenance Foreman			\$	
	Hrs. Water Maint. Man-1	at		\$	
6	Hrs. Water Maint. Man-2	at	1.613	\$	968
	Hrs. Garage Foreman	at		\$	
7	Hrs. Labor	at	1.30	\$	910
	Hrs. Compressor	at		\$	
	Compensation Ins.	at \$5.686 per C		\$	107
	Trucking			\$	1.56
	Pav't Patch			\$	9.10
	Tap by Gifford			\$	
			5-2-56	\$	
	O'head			\$	
				\$	
				\$	4704


2900

Second

St. ~~Pl.~~
Ave. No. 15

Name of Owner
Columbetti

Labor and Mat'l. Report May 2 1956

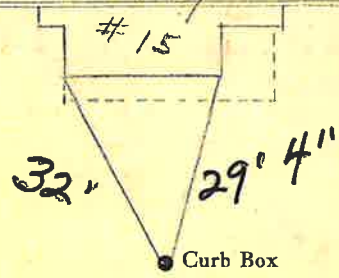

6" Main Elev. of Main at tap 5'

Gate at • Gate at

TAX ID # 309.12-7-31

12' to MAIN
3/4" COPPER