

LABOR AND MATERIALS

1	Copper head	Connection	3/4"	\$
1	Curb	Cock Valve	3/4 in. (MARKED ORIGINAL)	\$
1	Service box	Short 3 1/2 x 4 1/2		\$
	Old returned	Long 4 1/2 x 5 1/2		\$
		Bull or Rdway		\$
25	Ft. 3/4 in.	Copper Pipe		\$
	Nipples	in. at		\$
	Bushings	to in. at		\$
	Red'g Inc'g	Coupl'gs to in. at		\$
	Union	in. at		\$
	Meter	in. at		\$
	Lead Joints	at		\$
	Compound Joints	at		\$
	Maintenance Foreman			\$
	Hrs. Water Maint. Man-1	at		\$
	Hrs. Water Maint. Man-2	at		\$
	Hrs. Garage Foreman	at		\$
	Hrs. Labor	at		\$
	Hrs. Compressor	at		\$
	Compensation Ins.	at \$ per C		\$
	Trucking			\$
	Pav't Patch			\$
	O'head			\$


TAP MADE BY GIFFORD & CO

MAY-7-1973

Second St Ave. No. 20

Name of Owner JACKSON

Labor and Mat'l. Report MAY 7 19 73

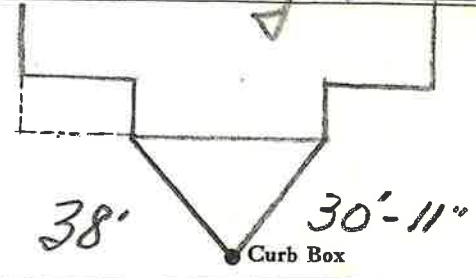

6" Main Elev. of Main at tap 5'

Gate at TAX ID# 309.12-10-15 Gate at

25' to main Curb Box
3/4" COPPER