


31-99

Labor and Material Report

Page 121 1971

22

See Below

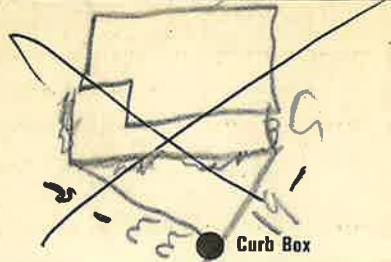

6" Main


Elev of Main at tap 5 1/2

Gate at 25' to main 3/4 COPPER

Gate at

Curb Box

Old tap disconnected

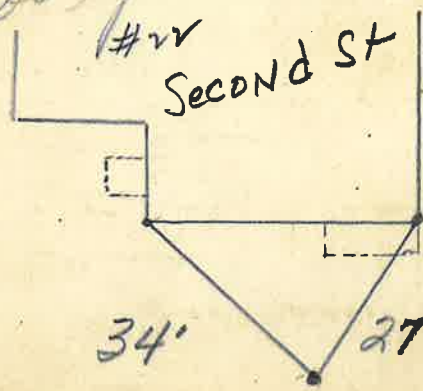


SECOND

St. Pl. Ave. No. 22

Name of Owner

TAX ID # 309.12-10-16

Labor and Mat'l. Report 3-10-2004

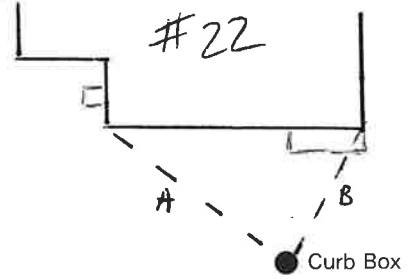

6" Main

Elev. of Main at tap 5'6"

Gate at

Gate at

25' OF COPPER TO MAIN

Curb Box

A = 35'3"  
B = 28'10"

