


LABOR AND MATERIALS

1 Copper } Connection 3/4" \$
 Lead }
 1 Curb } Cock } 3/4 in. O.P. seal. \$
 Valve }
 T.S. & V. }
 1 Service box { Short 3 1/2 x 4 1/2 }
 Old returned { Long 4 1/2 x 5 1/2 }
 { Buff or Rdway } \$
 11 Ft. 3/4 in. { Copper } Pipe at \$
 { G.I. }
 { G.I. }
 Nipples in. at \$
 Bushings to in. at \$
 Red'g }
 Inc'g } Coupl'gs. to in. at \$
 Union in. at \$
 Meter in. at \$
 Lead Joints at \$
 Compound Joints at \$
 Maintenance Foreman \$
 Hrs. Water Maint. Man-1 at \$
 Hrs. Water Maint. Man-2 at \$
 Hrs. Garage Foreman at \$
 Hrs. Labor at \$
 Hrs. Compressor at \$
 Compensation Ins. at \$ per C \$
 Trucking \$
 Pav't Patch \$
Tap by Seymour + Co. \$
5-18-71 \$
 O'head \$

St. Second
 Pl. 3
 Ave. No. 3

Name of Owner Alden.

Labor and Mat'l. Report May 18 19 71

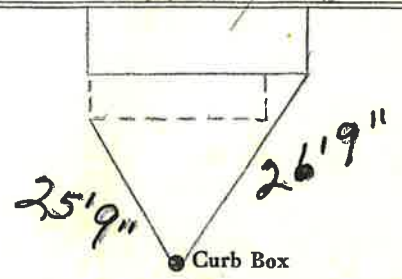

6" Main Elev. of Main at tap 5 1/2'
 Gate at • Gate at

TAX ID# 309.12-9-18

• Curb Box
11' to MAIN
3/4" COPPER