


Labor and Materials

Copper } Connection.....	3/4"	\$ 1.50
Lead }	3/4"	
Curb { Cock Valve }	3/4"	\$ 1.70
{ T.S. & V. }		
Service Box { Short 3 1/2 x 4 1/2 }		\$ 1.00
Old returned { Long 4 1/2 x 5 1/2 }		\$ 1.00
{ Buff. or Redway }		
24 Ft. 3/4 in. { Copper } Pipe at		\$ 4.56
{ Galv. Iron }		
{ Cast Iron }		
Nipples,	in. at	\$
Bushings	to	in. at \$
Red'g } Couplings	to	in. at \$
Inc'g }		
Union	in. at	\$
Meter	in. at	\$
Lbs. Br. Stone at		\$
Lbs. Sand at		\$
Bags Cement at		\$
Paving Brick { Mack } at		\$
{ Red }		
{ Asphalt }		
Lead Joints at		\$
Leadite Joints at		\$
5 Hrs. Foreman at	67.12	\$ 3.13
2 Hrs. Common Labor at	45	\$ 3.60
Hrs. Common Labor at		\$
Hrs. Mason at		\$
Hrs. Masons Helper at		\$
Hrs. Compressor at		\$
Compensation Ins		\$ 0.74
Trucking		\$ 1.-
Builders Use of Water <i>Four Pails</i>		\$ 5.-
Total \$		22.17

55 34
Labor and Material Report *Aug 21 1921*

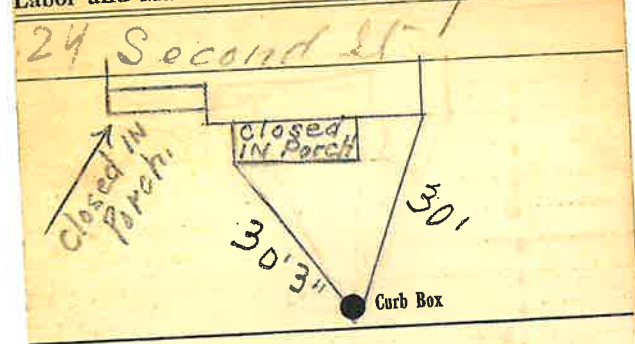

6 Main Elev. of Main at tap *5 1/2*

Gate at TAX ID # 309.12-10-17 Gate at

● Curb Box

old shut off at main

24' to MAIN

3/4" CAPPER