

Labor and Materials


1..	Copper	} Connection ^{3/4}	\$.1.50
1..	Lead			
1..	Curb	} Cock Valve T.S.&V. } ^{3/4} in	\$.1.70
1..	Service Box			
1..	Old returned	} Short 3 1/2 x 4 1/2 } Long 4 1/2 x 5 1/2 } Buff. or Rawdy }	\$.1.54
23	Ft. ^{3/4} in.			
	Copper Galv. Iron Cast Iron	} Pipe at	\$.6.67
	Nipples			
	Bushings to in. at	\$.
	Red'g Inc'g	} Couplings to in. at
	Union			
	Meter in. at	\$.
	Lbs. Br. Stone	at	\$.
	Lbs. Sand	at	\$.
	Bags Cement	at	\$.
	Paving Brick	} Mack Red Asphalt }	at
	Lead Joints			
	Leadite Joints	at	\$.
4	Hrs. Foreman	at	⁶ 2 1/2	\$.2.50
15	Hrs. Common Labor	at	45	\$.6.75
	Hrs. Common Labor	at	\$.
	Hrs. Mason	at	\$.
	Hrs. Masons Helper	at	\$.
	Hrs. Compressor	at	\$.
	Compensation Ins		\$.0.33
	Trucking		\$.1.00
	Builders Use of Water		\$.

Total \$21.99

120 34
Labor and Material Report

Sept 22 1926

28 ^{Second} St

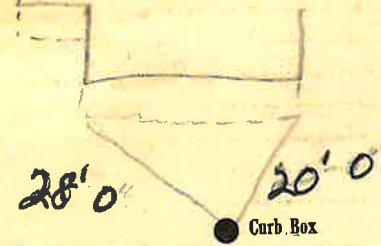

6" Main

Elev of Main at tap ⁵/₂

Gate at TAX ID # 309.12-7-27 Gate at

● Curb Box

old lead off at main
23' to main
3/4" COPPER
\$1.00

M Dewey