

Labor and Materials


| | |
|--|---------|
| 1...Copper } Connection... ^{3/4} | \$ 1.50 |
| 1...Lead | |
| 1...Curb { Cock Valve T.S.&V. } ^{3/4} in | \$ 1.70 |
| 1...Service Box { Short 8 1/2 x 4 1/2 Long 4 1/2 x 5 1/2 } | \$ 1.50 |
| Old returned { Buff. or Rdway } | |
| 23 Ft. 2 1/2 in. { Copper Galv. Iron Cast Iron } Pipe at | \$ 6.67 |
| Nipples in. at | \$ |
| Bushings to in. at | \$ |
| Red'g } Couplings.....to.....in.at... | \$ |
| Inc'g } | |
| Union.....in. at | \$ |
| Meter.....in. at | \$ |
| Lbs. Br. Stone at | \$ |
| Lbs. Sand at | \$ |
| Bags Cement at | \$ |
| Paving Brick { Mack Red Asphalt } at | \$ |
| Lead Joints at | \$ |
| Leadite Joints at | \$ |
| 4 Hrs. Foreman at 62 1/2 | \$ 2.50 |
| 19 Hrs. Common Labor at ... 45 | \$ 8.55 |
| Hrs. Common Labor at | \$ |
| Hrs. Mason at | \$ |
| Hrs. Masons Helper at | \$ |
| Hrs. Compressor at | \$ |
| Compensation Ins | \$ 0.41 |
| Trucking | \$ 2.- |
| Builders Use of Water | \$ |
| Total \$ 24.87 | |

87 34

Labor and Material Report

1921

30 Second St

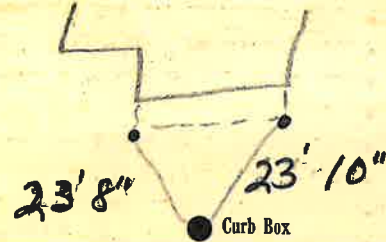

6" Main

Elev. of Main at tap

5 1/2'

Gate at

TAX ID# 309.12-16-20

Gate at

● Curb Box

old skt off at 9m

23' to main

3/4" COPPER

[Signature]

P
G. McCarthy