


**Labor and Materials**

1	Copper } Connection	3/4	\$
1	Lead } Connection		\$
1	Curb } Cock Valve T. S. & V. }	3/4 in.	\$
1	Service Box } Short 3/4 x 4 1/2 }		\$
	Old returned } Long 4 1/2 x 5 1/2 }		\$
		Buff. or Rdway }	\$
1/1	Ft. .... in. }	Copper Galv. Iron Cast Iron }	\$
1	Nipples. 3/4 in. at		\$
	Bushings. .... to .... in. at		\$
1	Red'g } Couplings. 3/4 to 1 in. at		\$
	Inc'g }		\$
	Union. .... in. at		\$
	Meter. .... in. at		\$
	Lbs. Br. Stone at		\$
	Lbs. Sand at		\$
	Bags Cement at		\$
	Paving Brick } Mack Red Asphalt }	at	\$
	Lead Joints at		\$
	Leadite Joints at		\$
3	Hrs. Foreman at		\$
6	Hrs. Common Labor at		\$
	Hrs. Common Labor at		\$
	Hrs. Mason at		\$
	Hrs. Mason's Helper at		\$
	Hrs. Compressor at		\$
	Compensation Ins.		\$
	Trucking		\$
	Builders' Use of Water		\$
Total \$			11.88

*no 31 1/2 second st*

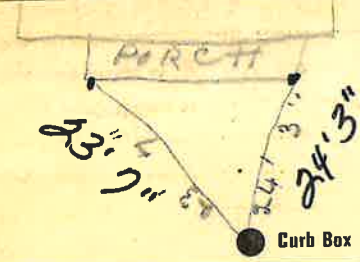

6" Main Elev. of Main at tap 5'

Gate at TAX ID # 309.12.7-24 Gate at

● Curb Box

*11' to main  
3/4" copper*