

LABOR AND MATERIALS

1	Copper Lead	Connection	3/4	\$	1.78
1	Curb	Clock Valve { T. S. & V. }	3/4 in.	\$	2.61
1	Service box Old returned	Short 3" X 4" Long 4" X 5" Buff or Rdway		\$	1.82
9	Ft.	3/4 in. { Copper Galv. Iron Cast Iron }	Pipe at 23	\$	2.07
	Nipples	in. at		\$	
	Bushings	to in. at		\$	
	Red'g Inc'g	Couplings	to in. at	\$	
	Union	in. at		\$	
	Meter	in. at		\$	
	Lead Joints at			\$	
	Compound Joints at			\$	
	Hrs. Foreman at			\$	
7	Hrs. Chauffeur at		75	\$	52.50
2	Hrs. Tapper at			\$	1.50
7	Hrs. Labor at		65	\$	45.50
	Hrs. Labor at			\$	
	Hrs. Compressor at			\$	
	Compensation Ins.			\$	31
	Trucking			\$	1.00
	Builders Use of Water	Patch		\$	5.00
	Tap 4 Wainscot			\$	
				\$	
				\$	
				\$	25.89

St.
Pt.
Ave. No.


Second

Name of Owner

Well's

Labor and Mat'l. Report

Mar 29 1946

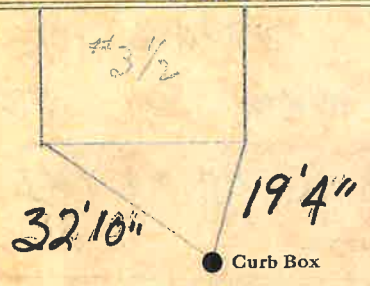

6

Main

Elev. of
Main at tap 5'

Gate at ●

● Gate at

TAX ID # 309.129-17

9' to MAIN ● Curb Box
3/4" COPPER