

Labor and Materials


1...Copper } Connection... $\frac{3}{4}$	\$ 1.50
1...Lead }	
1...Curb { Cock }	\$ 1.70
{ Valve }	
{ T.S.&V. }	
1...Service Box { Short $3\frac{1}{2} \times 4\frac{1}{2}$ }	\$ 1.50
Old returned { Long $4\frac{1}{2} \times 5\frac{1}{2}$ }	
{ Buff or Rdway }	
25...Ft. $\frac{3}{4}$ in. { Copper } Pipe at	\$ 4.75
{ Galv. Iron }	
{ Cast Iron }	
.....Nipples in. at	\$
.....Bushings to in. at	\$
.....Red'g } Couplings..... to in. at	\$
.....Inc'g }	
.....Union..... in. at	\$
.....Meter..... in. at	\$
.....Lbs. Br. Stone at	\$
.....Lbs. Sand at	\$
.....Bags Cement at	\$
.....Paving Brick { Mack } at	\$
{ Red }	
{ Asphalt }	
.....Lead Joints at	\$
.....Leadite Joints at	\$
5...Hrs. Foreman at 6×12	\$ 3.13
24...Hrs. Common Labor at .. 45	\$ 10.80
.....Hrs. Common Labor at	\$
.....Hrs. Mason at	\$
.....Hrs. Masons Helper at	\$
.....Hrs. Compressor at	\$
.....Compensation Ins	\$ 0.50
.....Trucking	\$ 2.-
.....Builders Use of Water	\$

Total \$ 25.92.

121 34
Labor and Material Report

Sept 22 1930

32 Second St

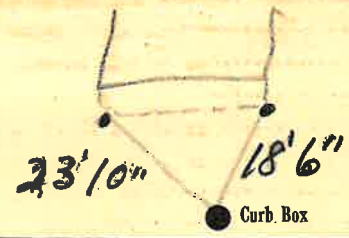

6" Main

Elev. of Main at tap $5\frac{1}{2}'$

Gate at TAX ID# 309.12-10-21 Gate at

● Curb Box

old shot off par main
25' to MAIN
 $\frac{3}{4}$ " COPPER

[Handwritten signature]

MM
Hurt