


Labor and Materials

..f..Copper } Connection.....	3	\$ 1.50
..f..Lead }	1	
..f..Curb { Cock Valve }	3	\$ 1.70
..f..Service Box { Short 3/4"x4 1/4" }	1	\$ 1.44
..f..Old returned { Long 4 1/2"x4 1/4" }		
..f..10 Ft. in. { Copper } Pipe at		\$ 1.90
..f..Nipples		\$
..f..Bushings		\$
..f..Red'g } Couplings.....to.....in.at...\$		
..f..Inc'g }		
..f..Union.....in. at		\$
..f..Meter.....in. at		\$
..f..Lbs. Br. Stone at		\$
..f..Lbs. Sand at		\$
..f..Bags Cement at		\$
..f..Paving Brick { Mack Red Asphalt } at		\$
..f..Lead Joints at		\$
..f..Leadite Joints at		\$
..f..3 Hrs. Foreman at	6 2/3	\$ 1.89
..f..10 Hrs. Common Labor at	4.5	\$ 4.50
..f..Hrs. Common Labor at		\$
..f..Hrs. Mason at		\$
..f..Hrs. Masons Helper at		\$
..f..Hrs. Compressor at		\$
..f..Compensation Ins		\$ 0.23
..f..Trucking		\$ 1.1-
..f..Builders Use of Water <u>Part Patch</u>		\$ 5.-
Total \$		19.15..

94 34

Labor and Material Report Aug 20 1934

33 Second St.

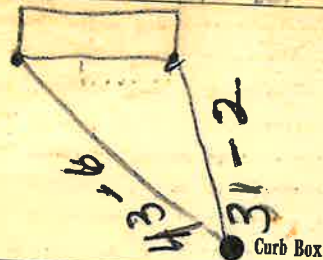

6" Main

Elev. of Main at tap 5 1/2

Gate at TAX ID # 309.12-1-23 Gate at

10' to main Curb Box
3/4" COPPER
old shot off at
Main

To be changed

FM