

Labor and Materials


1	Copper	Connection $3/4$ "	\$ 1.50
1	Lead		
1	Curb	{ Cock Valve T.S.&V. } $3/4$ " in	\$ 1.70
1	Service Box	{ Short $3\frac{1}{2} \times 4\frac{1}{2}$ Long $4\frac{1}{2} \times 5\frac{1}{2}$	\$ 1.50
	Old returned	{ Buff. or Rdway	
24	Ft. $3/4$ " in.	{ Copper Galv. Iron Cast Iron } Pipe at	\$ 4.56
	Nipples	in. at	\$
	Bushings	to in. at	\$
	Red'g Inc'g	{ Couplings to in. at	\$
	Union	in. at	\$
	Meter	in. at	\$
	Lbs. Br. Stone	at	\$
	Lbs. Sand	at	\$
	Bags Cement	at	\$
	Paving Brick	{ Mack Red Asphalt } at	\$
	Lead Joints	at	\$
	Leadite Joints	at	\$
A	Hrs. Foreman	at 6.25	\$ 7.50
1	Hrs. Common Labor	at 50	\$ 50
17	Hrs. Common Labor	at 45	\$ 7.65
	Hrs. Mason	at	\$
	Hrs. Masons Helper	at	\$
	Hrs. Compressor	at	\$
	Compensation Ins		\$ 0.28
	Trucking		\$ 2.1
	Builders Use of Water		\$

Total \$ 22.33

122 34

Labor and Material Report *Sept 24* 19*22*

*34 Second St*

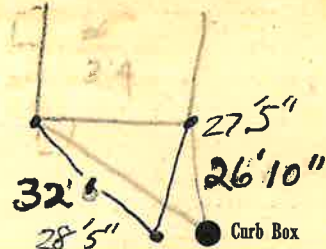

CLEAN OUT

6 Main

Elev. of Main at tap *5 1/2*

Gate at *TAX ID # 309.12-10-22* Gate at

● Curb Box

*old shut off at main  
24' to MAIN  
3/4" copper*

*Free Invoice only*