


**Labor and Materials**

.....Copper } Connection.....	.....\$ 1.50
.....Lead } .....	.....
.....Curb { Cock Valve T.S.&V. } 3" in .....	.....\$ 1.70
.....Service Box { Short 3 1/2 x 4 1/2 Long 4 1/2 x 5 1/2 Buff. or Rdway } .....	.....\$ 1.54
12 Ft. 2 1/2 in. { Copper Galv. Iron Cast Iron } Pipe at .....	.....\$ 2.28
.....Nipples .....in. at .....	.....\$ .....
.....Bushings .....to .....in. at .....	.....\$ .....
.....Red'g } Couplings.....to.....in.at.....	.....\$ .....
.....Inc'g } .....	.....
.....Union.....in. at .....	.....\$ .....
.....Meter.....in. at .....	.....\$ .....
.....Lbs. Br. Stone at .....	.....\$ .....
.....Lbs. Sand at .....	.....\$ .....
.....Bags Cement at .....	.....\$ .....
.....Paving Brick { Mack Red Asphalt } at .....	.....\$ .....
.....Lead Joints at .....	.....\$ .....
.....Leadite Joints at .....	.....\$ .....
3 Hrs. Foreman at ..... 4 1/2 .....	.....\$ 1.88
12 Hrs. Common Labor at ... 45 .....	.....\$ 5.40
.....Hrs. Common Labor at .....	.....\$ .....
.....Hrs. Mason at .....	.....\$ .....
.....Hrs. Masons Helper at .....	.....\$ .....
.....Hrs. Compressor at .....	.....\$ .....
.....Compensation Ins .....	.....\$ 0.26
.....Trucking .....	.....\$ 1.15
.....Builders Use of Water .....	.....\$ .....
Total \$ 15.56	

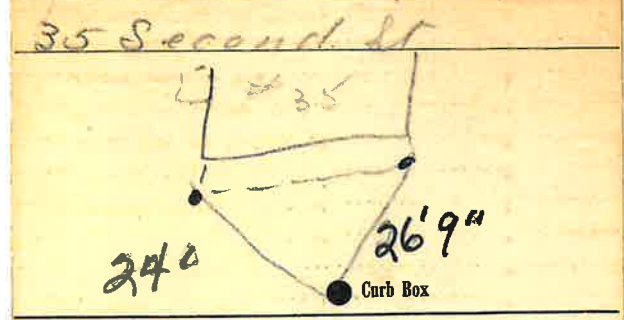

6" Main Elev. of Main at tap \_\_\_\_\_

Gate at ● TAX ID # 309.12-7-22 ● Gate at

● Curb Box

*old shut off at 9m*

*12' to main*

*3/4" COPPER*

*JMD*

*JMD*