

Labor and Materials


Copper } Connection	2	\$ 3.20
Lead } Connection	1/4	
Curb } Cock		\$ 1.00
} Valve		
} T.S. & V.		
Service Box } Short 3/4 x 1/2		\$ 1.30
Old returned } Long 1/2 x 5/8		
} Butt or Redway		
24 Ft. } in. Copper	3	\$ 5.28
} in. Cast Iron	7	
} Pipe at		
Nipples	in. at	\$
Bushings	to in. at	\$
Red'g } Couplings	to in. at	\$
Inc'g }		
Union	in. at	\$
Meter	in. at	\$
Lbs. Br. Stone	at	\$
Lbs. Sand	at	\$
Bags Cement	at	\$
Paving Brick } Mack	at	\$
} Red		
} Asphalt		
Lead Joints	at	\$
Leadite Joints	at	\$
9 Hrs. Foreman	at	\$ 1.88
12 Hrs. Common Labor	at	\$ 4.88
Hrs. Common Labor	at	\$
Hrs. Mason	at	\$
Hrs. Mason's Helper	at	\$
Hrs. Compressor	at	\$
Compensation Ins		\$ 18
Trucking		\$ 1.00
Builders' Use of Water		\$
Total \$		18.22

28-138

Labor and Material Report

Oct 6 1920

36 Second St

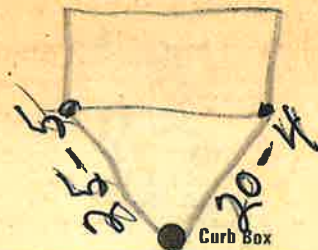

6" Main

Elev of Main at tap

5'

Gate at

TAX ID # 309.12-10-23

Gate at

● Curb Box

old Tap shut off
24' to main
3/4" COPPER