


Labor and Materials

1	Copper	} Connection	3/4"	\$. 1.50			
1	Lead							
1	Curb	} Cock Valve T.S.&V.	3/4" in	\$. 1.70			
1	Service Box Old returned							
			{ Short 3 1/2 x 4 1/2	\$. 1.50			
			{ Long 4 1/2 x 5 1/2					
20	Ft. 3/4 in.	} Copper Galv. Iron Cast Iron	Pipe at	\$. 3.80			
	Nipples						in. at
	Bushings	to	in. at	\$.	
	Red'g Inc'g	} Couplings	to	in. at	\$.
	Union							
	Meter	in. at	\$.			
	Lbs. Br. Stone	at	\$.				
	Lbs. Sand	at	\$.				
	Bags Cement	at	\$.				
	Paving Brick	} Mack Red Asphalt	} at	\$.			
	Lead Joints					at	\$.
	Leadite Joints	at	\$.				
4	Hrs. Foreman	at	6 1/2 hr.	\$. 2.50			
18	Hrs. Common Labor	at	4.5	\$. 8.10			
	Hrs. Common Labor	at	\$.				
	Hrs. Mason	at	\$.				
	Hrs. Masons Helper	at	\$.				
	Hrs. Compressor	at	\$.				
	Compensation Ins	\$. 0.28			
	Trucking	\$. 2.-			
	Builders Use of Water	\$.			
Total					\$. 21.57			

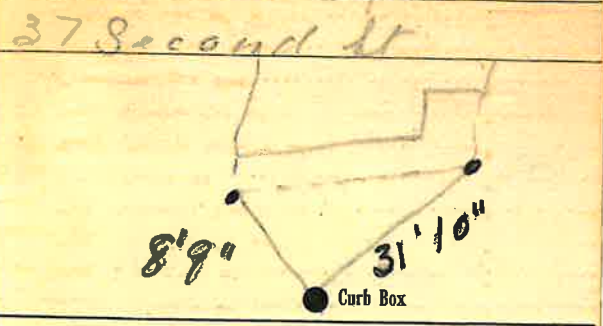

6" Main
Elev. of Main at tap 5 1/2'

Gate at TAX ID # 309.12-7-21 Gate at

● Curb Box

old shut off at main
20' to main
3/4" copper

[Signature]

1/2" Fred Monty