

LABOR AND MATERIALS

1 Copper Connection  $\frac{3}{4}$ " \$  
 1 Curb Cock  $\frac{3}{4}$  in. (MAY 12) \$  
 1 Service box Short  $3\frac{1}{2} \times 4\frac{1}{2}$  \$  
 Old returned Long  $4\frac{1}{2} \times 5\frac{1}{2}$  \$  
 Buff or Rdwny  $4'-5"$  \$  
 9  $\frac{3}{4}$  in. Copper Pipe at \$  
 Nipples in. at \$  
 Bushings to in. at \$  
 Red'g } Coupl'gs to in. at \$  
 Inc'g }  
 Union in. at \$  
 Meter in. at \$  
 Lead Joints at \$  
 Compound Joints at \$  
 Maintenance Foreman \$  
 Hrs. Water Maint. Man-1 at \$  
 Hrs. Water Maint. Man-2 at \$  
 Hrs. Garage Foreman at \$  
 Hrs. Labor at \$  
 Hrs. Compressor at \$  
 Compensation Ins. at \$ per C \$  
 Trucking \$  
 Pav't Patch \$  
 Tap made By G. Ford & Co \$  
 O'head JUNE-10-1974 \$  
 \$

Second


St. No. 45  
 Ave. No.

Name of Owner

Patricia Blake

Labor and Mat'l. Report

JUNE 10 1974

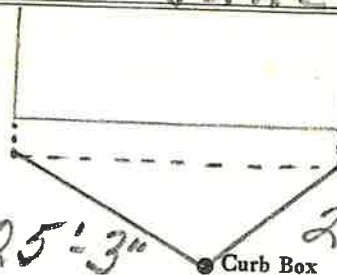

6" Main

Elev. of Main at tap  $5\frac{1}{2}$ "

Gate at ●

● Gate at

TAX ID # 309.11-7-26

9' to MAIN ● Curb Box  
 $\frac{3}{4}$ " COPPER