

Labor and Materials

1	Copper } Connection.....	3/4	\$3.70
1	Lead } Cock		
	Valve		
	T. S. & V. } in.....		\$1.00
1	Service Box } Short 2 1/2 x 4 1/2		
	Old returned } Long 4 1/2 x 5 1/2		\$1.20
		Buff. or Putaway	
8	Ft. in. } Copper	3	
		Galv. Iron	
		Cast Iron	
	Pipe at.....		\$17.6
	Nipples..... in. at.....		\$
	Bushings..... to..... in. at.....		\$
	Red'g } Couplings..... to..... in. at.....		\$
	Inc'g }		
	Union..... in. at.....		\$
	Meter..... in. at.....		\$
	Lbs. Br. Stone at.....		\$
	Lbs. Sand at.....		\$
	Bags Cement at.....		\$
	Paving Brick } Mack		
		Red	
		Asphalt	
	at.....		\$
	Lead Joints at.....		\$
	Leadite Joints at.....		\$
2	Hrs. Foreman at.....		\$1.25
9	Hrs. Common Labor at.....		\$26.6
	Hrs. Common Labor at.....		\$
	Hrs. Mason at.....		\$
	Hrs. Mason's Helper at.....		\$
	Hrs. Compressor at.....		\$
	Compensation Ins.....		\$.10
	Trucking.....		\$1.00
	Builders' Use of Water.....		\$


Total \$ 13.40

7890

Labor and Material Report

Aug. 2 1928

47 Second St.

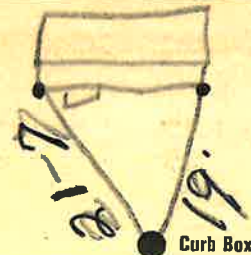

6" Main

Elev of Main at tap 50

Gate at

TAX ID # 309.11-7-25

Gate at

Curb Box

old tap shut off
8' to main
3/4" copper