

### LABOR AND MATERIALS

1	Copper	Connection	3/4"		\$ 2.41
	Lead				
1	Curb	Cock Valve T.S. & V.	3/4" in.		\$ 3.41
1	Service box	Short 3 1/2 x 4 1/2			
	Old returned	Long 4 1/2 x 5 1/2			
		Buff or Rdway.			\$ 4.18
10	3/4 in.	Copper Pipe at	40		\$ 4.00
		G.I.			
		G.I.			
	Nipples	in. at			\$
	Bushings	to in. at			\$
	Red'g				
	Inc'g	Coupl'gs to in. at			\$
	Union	in. at			\$
	Meter	in. at			\$
	Lead Joints	at			\$
	Compound Joints	at			\$
	Maintenance Foreman				\$ 27.95
	Hrs. Water Maint. Man-1	at			\$
6 1/2	Hrs. Water Maint. Man-2	at 1.24			\$ 8.06
4	Hrs. Garage Foreman	at 1.59			\$ 6.36
12	Hrs. Labor	at 1.13			\$ 13.56
	Hrs. Compressor	at			\$
	Compensation Ins. at \$3.81	per C.			\$ 1.08
	Trucking				\$ 1.50
	Pay't Patch				\$ 7.20
	Tap by Giesbard	10-14-54			\$
	O'head				\$
					\$ 51.76


44.56

90-54

Second St. Ave. No. 49

Name of Owner  
Goldstein

Labor and Mat'l. Report Oct. 14 1954

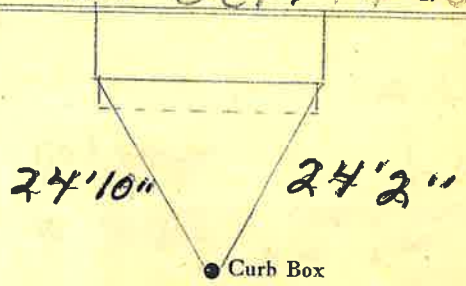

6" Main Elev. of Main at tap 5'

Gate at • Gate at

TAX ID # 309.11-7-24

10' to MAIN • Curb Box

3/4" COPPER

Old Tap disconnected at Main Oct 14-54