


Labor and Materials

1	Copper	Connection	3/4"	\$ 3.20
1	Curb	Cock Valve	3/4" in.	\$ 1.00
1	Service Box	Short 3 1/2 x 4 1/2		\$ 1.20
	Old returned	Long 1 1/2 x 5 1/2	Buff. or Redway	
1 1/2	Ft.	3/4" in. Copper	Pipe at	\$ 2.42
		Galv. Iron		
		Cast Iron		
	Nipples	in. at		\$
1	Bushings	3/4" to 1/2" in. at		\$.08
	Red'g Inc'g	Couplings	to in. at	\$
	Union	in. at		\$
	Meter	in. at		\$
	Lbs. Br. Stone	at		\$
	Lbs. Sand	at		\$
	Bags Cement	at		\$
	Paving Brick	Mack Red Asphalt	at	\$
	Lead Joints	at		\$
	Leadite Joints	at		\$
2	Hrs. Foreman	at	6.25	\$ 1.25
	Hrs. Common Labor	at		\$
1.25	Hrs. Common Labor	at	4.07	\$ 4.97
	Hrs. Mason	at		\$
	Hrs. Mason's Helper	at		\$
	Hrs. Compressor	at		\$
	Compensation Ins.			\$.17
	Trucking			\$ 1.00
	Builders' Use of Water			\$

Total \$ 15.99

26-31
 Labor and Material Report June 1 19 26

51 Second St

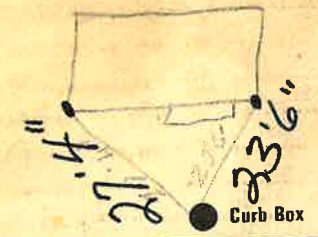

6" Main Elev. of Main at tap 5'
 Gate at TAX ID # 309.11-7-23 Gate at

Curb Box
 11' to MAIN
 3/4" Copper
 Renewal