


24-78

Labor and Material Report June 30 1929

57 Second St

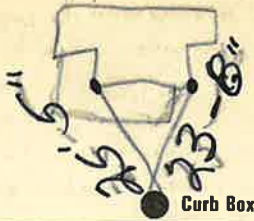

6

Main

Elev of Main at tap

5

Gate at

TAX ID # 309.11-7-20

Gate at

● Curb Box

10' to MAIN
 3/4" COPPER
 old tap shut off

SECOND


St. Pl. Ave. No.

57

Name of Owner

OUTSIDE CLEAN OUT

Labor and Mat'l. Report 19

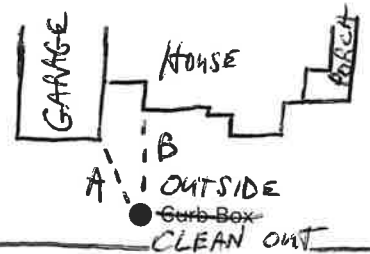

STAPLE ST.

Main

Elev. of Main at tap

Gate at

Gate at

● Curb Box

A = 21

B = 27

