


Leads
Labor and Materials

Lead Connection	\$
$\frac{3}{4}$ " Curb Cock	\$
Service Box { Short $3\frac{1}{2}$ x $4\frac{1}{2}$	\$
Old returned { Long 4 x 5 } Buffalo	\$
23' Ft. in. Gal. Pipe at	\$
Nipples in. at	\$
Bushings in. at	\$
Red'g Coup ... to ... in. at	\$
Inc'g Coup ... to ... in. at	\$
Union in. at	\$
Meter in. at	\$
Cu. Yds. Br. Stone at	\$
Cu. Yds. Sand at	\$
Bags Cement at	\$
Pav. Brick { Mack Red Asphalt } at	\$
Hrs. Foreman at	\$
19 Hrs. Com. Labor at	\$
Hrs. Mason at	\$
Hrs. at	\$
Hrs. at	\$
Builders' Use of Water	\$
..... at	\$
..... at	\$
..... at	\$
..... at	\$
Total	\$	

Labor and Material Report

19

6 Second Street

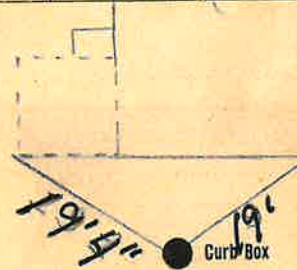

6 Main

Elev. of Main at tap 6

Gate at ●

● Gate at

TAX ID # 309.12-10-8

● Curb Box

23' to main

$\frac{3}{4}$ " BRASS CONNECTION