

LABOR AND MATERIALS

1	Copper Lead	Connection	3/4	\$
1	Curb	Cock Valve T.S. & V.	3/4 in.	\$
1	Service box Old returned	Short 3 1/2 x 4 1/2 Long 4 1/2 x 5 1/2 Buff or Rdway		\$
22	Ft.	3/4 in. Copper C.I. C.I.	Pipe at	\$
	Nipples	in. at		\$
	Bushings	to in. at		\$
	Red'g Inc'g	Coupl'gs to in. at		\$
	Union	in. at		\$
	Meter	in. at		\$
	Lead Joints	at		\$
	Compound Joints	at		\$
	Maintenance Foreman			\$
	Hrs. Water Maint. Man-1	at		\$
	Hrs. Water Maint. Man-2	at		\$
	Hrs. Garage Foreman	at		\$
	Hrs. Labor	at		\$
	Hrs. Compressor	at		\$
	Compensation Ins.	at \$ per C		\$
	Trucking			\$
	Pav't Patch			\$
	Tap May 30, 1978			\$
	Freeman & Co.			\$
	O'head			\$


Second

St. Pt. Ave. No. 8

Name of Owner

Larry Robillard

Labor and Mat'l. Report May 30 1978

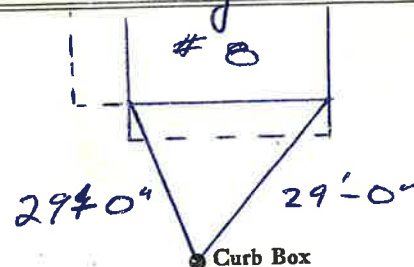

6" Main

Elev. of Main at tap 5'

Gate at •

• Gate at

TAX ID # 309.12-10-9

22' to main • Curb Box
3/4" COPPER