


### Labor and Materials

.../. Copper } Connection... $\frac{3}{4}$ .....	\$ 1.50
.../. Lead } .....	
.../. Curb { Cock Valve T.S.&V. } $\frac{3}{4}$ in .....	\$ 1.70
.../. Service Box { Short $3\frac{1}{2} \times 4\frac{1}{2}$ } .....	\$ 1.54
Old returned { Long $4\frac{1}{2} \times 5\frac{1}{2}$ } .....	
12 Ft. $\frac{3}{4}$ in. { Copper Galv. Iron } Pipe at .....	\$ 2.28
..... Cast Iron } .....	
..... Nipples ..... in. at .....	\$ .....
..... Bushings ..... to ..... in. at .....	\$ .....
..... Red'g Inc'g } Couplings..... to ..... in. at .....	\$ .....
..... Union..... in. at .....	\$ .....
..... Meter..... in. at .....	\$ .....
..... Lbs. Br. Stone at .....	\$ .....
..... Lbs. Sand at .....	\$ .....
..... Bags Cement at .....	\$ .....
..... Paving Brick { Mack Red Asphalt } at .....	\$ .....
..... Lead Joints at .....	\$ .....
..... Leadite Joints at .....	\$ .....
6 Hrs. Foreman at .....	\$ 5.-
6 Hrs. Common Labor at .....	\$ 3.-
1.4 Hrs. Common Labor at .....	\$ 6.30
..... Hrs. Mason at .....	\$ .....
..... Hrs. Masons Helper at .....	\$ .....
..... Hrs. Compressor at .....	\$ .....
..... Compensation, Ins .....	\$ 0.51
..... Trucking .....	\$ 3.-
..... Builders Use of Water .....	\$ .....
Total \$ 24.83	

*9 Second St*

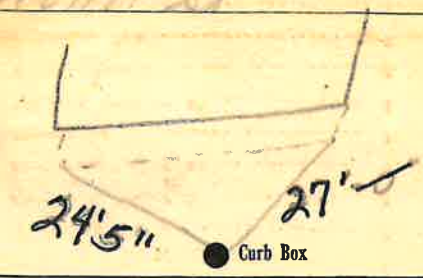

$6''$  Main Elev. of Main at tap  $5\frac{1}{2}$

Gate at TAX ID # 309.12-8-17 Gate at

● Curb Box  
*12' to main*  
 *$\frac{3}{4}''$  copper*

*old shut off fat main*

*J. Jones*