

LABOR AND MATERIALS

1	Copper	} Connection	_____	\$ _____	
1	Lead		_____	\$ _____	
1	Curb	} Cock Valve T. S. & V. }	_____ in.	\$ _____	
_____	Service box		} Short 3 1/2 x 4 1/2 Long 4 1/2 x 5 1/2 Buff or Rdway }	_____	\$ _____
_____	Old returned			_____	\$ _____
24	Ft. 1" in.	} Copper G.I. C.I. }	Pipe at _____	\$ _____	
_____	Nipples		_____ in. at _____	\$ _____	
_____	Bushings	_____ to _____ in. at _____	\$ _____		
_____	Red'g } Inc'g }	} Coupl'gs	_____ to _____ in. at _____	\$ _____	
_____	Union		_____ in. at _____	\$ _____	
_____	Meter	_____ in. at _____	\$ _____		
_____	Lead Joints	at _____	\$ _____		
_____	Compound Joints	at _____	\$ _____		
_____	Maintenance Foreman	_____	\$ _____		
_____	Hrs. Water Maint. Man-1	at _____	\$ _____		
_____	Hrs. Water Maint. Man-2	at _____	\$ _____		
_____	Hrs. Garage Foreman	at _____	\$ _____		
_____	Hrs. Labor	at _____	\$ _____		
_____	Hrs. Compressor	at _____	\$ _____		
_____	Compensation Ins. at \$ _____	per C _____	\$ _____		
_____	Trucking	_____	\$ _____		
_____	Pav't Patch	_____	\$ _____		
_____	O'head	_____	\$ _____		

REAR BINLYS


SHERDIAN

St. Pl. Ave. No. 6

Name of Owner _____

Labor and Mat'l. Report

19 78

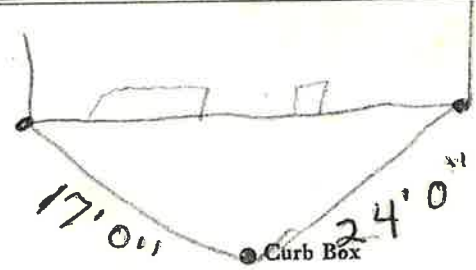

6 Main

Elev. of Main at tap 5

Gate at •

• Gate at

• Curb Box

24' to MAIN
1" COPPER