

Labor and Materials


1	Copper } Connection		\$ 320
1	Curb } Cock Valve T. S. & V. } 3 in		\$ 120
1	Service Box } Short 3 1/2 x 4 1/2 } Old returned } Buff or Redway }		\$ 130
25	Ft. 3/4 in. } Copper Galv. Iron Cast Iron } Pipe at		\$ 5.50
	Nipples..... in. at.....		\$
	Bushings..... to..... in. at.....		\$
	Red'g } Couplings..... to..... in. at.....		\$
	Union..... in. at.....		\$
	Meter..... in. at.....		\$
	Lbs. Br. Stone at.....		\$
	Lbs. Sand at.....		\$
	Bags Cement at.....		\$
	Paving Brick } Mack Red Asphalt } at.....		\$
	Lead Joints at.....		\$
	Leadite Joints at.....		\$
3	Hrs. Foreman at.....	187	\$
4	Hrs. Common Labor at.....	50	\$ 4.50
8	Hrs. Common Labor at.....	40.6	\$ 3.25
	Hrs. Mason at.....		\$
	Hrs. Mason's Helper at.....		\$
	Hrs. Compressor at.....		\$
	Compensation Ins.....	24	\$
1	Trucking.....	1.50	\$
	Builders' Use of Water.....		\$
	Total	2136	\$

Labor and Material Report

July 18 19 27

10 Sheridan St

East of
Crandall
St.

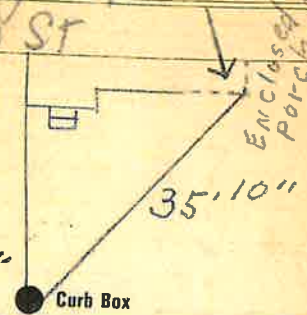

2" Main

Elev. of Main at tap 4 1/2

Gate at TAX ID# 302.19-11-9 Gate at

Curb Box

New lap
25' to MAIN
3/4" COPPER