


Labor and Materials

1. Lead Copper } Connection.....	2	96
1. Curb { Cock }	3	133
{ Valve }	4	
{ G.S.V. }		
1. Service Box { Short 3/4 x 4 1/2 }		135
Old returned { Long 4 1/2 x 5 1/2 }		
{ Bell or Bdw. }		
9. Ft. 3/4 in. { Copper } Pipe at 15 \$.)		35
{ Galv. Iron }		
{ Cast Iron }		
..... Nipples in. at		\$.....
..... Bushings to in. at		\$.....
..... Red'g } Couplings..... to..... in. at.....		\$.....
..... Inc'g }		\$.....
..... Union..... in. at		\$.....
..... Meter..... in. at		\$.....
..... Lbs. Br. Stone at		\$.....
..... Lbs. Sand at		\$.....
..... Bags Cement at		\$.....
..... Paving Brick { Mack } at		\$.....
{ Red }		
{ Asphalt }		
..... Lead Joints at		\$.....
..... Leadite Joints at		\$.....
..... Hrs. Foreman at		\$.....
..... Hrs. Common Labor at		\$.....
..... Hrs. Common Labor at		\$.....
..... Hrs. Mason at		\$.....
..... Hrs. Masons Helper at		\$.....
..... Hrs. Compressor at		\$.....
..... Compensation Ins		\$.....
..... Trucking		\$.....
..... Builders Use of Water <i>no patch</i>		\$.....
		<i>B.P.</i>
Total \$.....		

29 Sheppard St

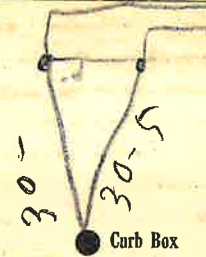

6 Main Elev. of Main at tap 4 1/2

Gate at TAX ID # 302.19-5-14 Gate at

● Curb Box
old shot off at main
(to be charged)
Callahan
9' to MAIN
3/4" Copper