


Labor and Materials

Copper } Connection	$\frac{3}{4}$	\$	320
Lead } Connection	$\frac{3}{4}$	\$	
Curb { Cock	in. $\frac{3}{4}$	\$	100
Valve			
T. S. & V.			
Service Box { Short $3\frac{1}{2} \times 4\frac{1}{2}$	}	\$	130
Old returned { Long $4\frac{1}{2} \times 5\frac{1}{2}$			
Bull. or Railway			
26 Ft. $\frac{3}{4}$ in. { Copper	Pipe at $\frac{3}{4}$	\$	572
Galv. Iron			
Cast Iron			
Nipples	in. at	\$	
Bushings	to in. at	\$	
Red'g } Couplings	to in. at	\$	
Inc'g }			
Union	in. at	\$	
Meter	in. at	\$	
Lbs. Br. Stone	at	\$	
Lbs. Sand	at	\$	
Bags Cement	at	\$	
Paving Brick { Mack	} at	\$	
Red			
Asphalt			
Lead Joints	at	\$	
Leadite Joints	at	\$	
3 Hrs. Foreman	at 62.5	\$	188
Hrs. Common Labor	at	\$	
16 Hrs. Common Labor	at 40.50	\$	650
Hrs. Mason	at	\$	
Hrs. Mason's Helper	at	\$	
Hrs. Compressor	at	\$	
Compensation Ins.		\$	23
Trucking		\$	100
Builders' Use of Water		\$	
Total \$			2083

Labor and Material Report *Sept 20* 19 *26*

1632 Sheridan St.

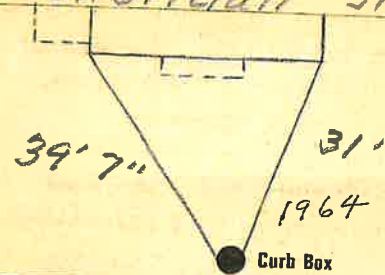

TAX ID # 302.19-10-10

6 Main Elev. of Main at tap *4 1/2*
 Gate at ● Gate at ●

● Curb Box

26' to main
3/4" copper