


Labor and Materials

1	Copper	Connection	3/4	\$ 2.60
1	Lead			
1	Curb	Cock Valve	in.	\$ 2.27
1	Service Box	Short 3/4x1/2		
	Old returned	Long 1/2x5/8		\$ 1.38
		Buff. or Rdway		
24	Ft.	Copper	Pipe at	\$ 4.32
		Galv. Iron		
		Cast Iron		
	Nipples	in. at		\$
1	Bushings	3/4 to 1/2	in. at	\$.10
	Red'g Inc'g	Couplings	to in. at	\$
	Union	in. at		\$
	Meter	in. at		\$
	Lbs. Br. Stone	at		\$
	Lbs. Sand	at		\$
	Bags Cement	at		\$
	Paving Brick	Mack Red Asphalt	at	\$
	Lead Joints	at		\$
	Leadite Joints	at		\$
1 1/2	Hrs.	Foreman	at	\$ 9.4
1 3/4	Hrs.	Common Labor	at Tapper	\$ 8.8
1 3/4	Hrs.	Common Labor	at	\$ 6.05
	Hrs	Mason	at	\$
	Hrs	Mason's Helper	at	\$
	Hrs.	Compressor	at	\$
	Compensation	Ins		\$ 24
	Trucking			\$ 1
	Builders' Use of Water			\$
Total \$				19.85

#20 Sheridan Ave.

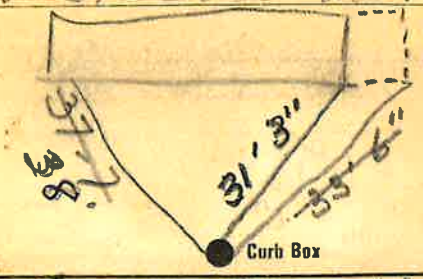

TAP ON GARFIELD ST.
6 Main Elev of Main at tap 5

Gate at TAX ID # 302.19-9-3 Gate at

Curb Box

1 Old tap disc
24' to MAIN
3/4" COPPER