

LABOR AND MATERIALS

Copper	} Connection	_____	\$ _____	
Lead				
Curb	} Cock Valve } T.S. & V. }	_____ in.	\$ _____	
Service box		} Short 3½ x 4½ } Long 4½ x 5½ } Buff or Rdway }	_____	\$ _____
Old returned				
11 Ft. ¾ in.	} Copper } G.I. } C.I. }	Pipe at _____	\$ _____	
Nipples	_____ in. at _____	\$ _____		
Bushings	_____ to _____ in. at _____	\$ _____		
Red'g } Inc'g }	} Coupl'gs _____ to _____ in. at _____	\$ _____		
Union		_____ in. at _____	\$ _____	
Meter	_____ in. at _____	\$ _____		
Lead Joints	at _____	\$ _____		
Compound Joints	at _____	\$ _____		
Maintenance Foreman	_____	\$ _____		
Hrs. Water Maint. Man-1	at _____	\$ _____		
Hrs. Water Maint. Man-2	at _____	\$ _____		
Hrs. Garage Foreman	at _____	\$ _____		
Hrs. Labor	_____ at _____	\$ _____		
Hrs. Compressor	at _____	\$ _____		
Compensation Ins.	at \$ _____ per C	\$ _____		
Trucking	_____	\$ _____		
Pav't Patch	_____	\$ _____		
	_____	\$ _____		
	_____	\$ _____		
O'head	_____	\$ _____		
	_____	\$ _____		


42 Sheridan St. Pt. Ave. No. 42

Name of Owner \_\_\_\_\_

TAX ID # 302.19-9-4

¾" TAP

Labor and Mat'l. Report May 14 1980

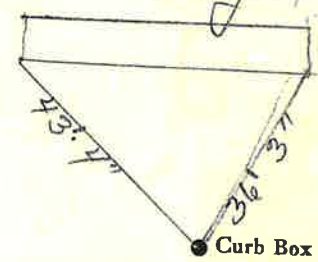

6" Main Elev. of Main at tap 4'

Gate at • Gate at •

• Curb Box

remeasured 5/14/80

11' to main

¾" copper

L.V.