


Labor and Materials

✓ 1	Lead Connection	1/2	\$
✓ 1	Curb Cock	5/8	\$
✓ 1	Service Box	{ Short 3 1/2 x 4 1/2 Long 4 1/2 x 5 1/2 Buffalo	\$
23	Ft. 2 1/2 in. G. I. Pipe at		\$
	Nipples	in. at	\$
	Bushings	in. at	\$
	Red'g Coup	to in. at	\$
	Inc'g Coup	to in. at	\$
	Union	in. at	\$
	Meter	in. at	\$
	Cu. Yds. Br. Stone at		\$
	Cu. Yds. Sand at		\$
	Bags Cement at		\$
	Pav. Brick	{ Mack Red Asphalt } at	\$
2	Hrs. Foreman at		\$
16	Hrs. Com. Labor at		\$
	Hrs. Mason at		\$
	Hrs.	at	\$
	Hrs.	at	\$
yes	Builders' Use of Water		\$
	Truck	100	\$
		at	\$
		at	\$
		at	\$
	Total	\$ 11.77	

Labor and Material Report June 16 1923

^{#43} Sheridan St 1/2 Tap

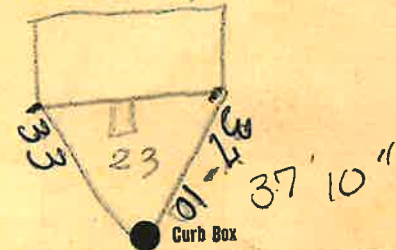

TAX ID # 302.19-4-14

6 Main

Elev. of Main at tap 4 1/2

Gate at ●

● Gate at

● Curb Box

23' to MAIN

3/4" GAL.

Drawn in Book July 11, 1923