


Labor and Materials

1	Copper } Connection	3/4	\$ 1.48
	Lead }		
	Curb { Cock Valve T.S.&V. }	3/4 in	\$ 1.79
1	Service Box { Short 3 1/2 x 4 1/2 Long 4 1/2 x 5 1/2 } Old returned { Buff. or Rdway }		\$ 1.46
8	Ft. 3/4 in. { Copper Galv. Iron Cast Iron } Pipe at		\$ 1.44
	Nipples	in. at	\$
	Bushings	to in. at	\$
	Red'g } Couplings	to in. at	\$
	Inc'g }		
	Union	in. at	\$
	Meter	in. at	\$
	Lbs. Br. Stone	at	\$
	Lbs. Sand	at	\$
	Bags Cement	at	\$
	Paving Brick { Mack Red Asphalt }	at	\$
	Lead Joints	at	\$
	Leadite Joints	at	\$
3	Hrs. Foreman	at	\$ 1.88
6	Hrs. Common Labor	at	\$ 2.70
	Hrs. Common Labor	at	\$
	Hrs. Mason	at	\$
	Hrs. Masons Helper	at	\$
	Hrs. Compressor	at	\$
	Compensation Ins	at	\$ 1.14
	Trucking	at	\$ 1.00
	Builders Use of Water Patch (burr)	at	\$ 2.50
Total \$			14.39

Labor and Material Report

June 3 1922

24 Sheridan St

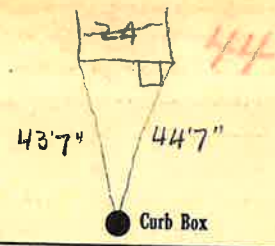

6 Main Elev. of Main at tap 4 1/2

Gate at TAX ID # 302.19-9-5 Gate at

● Curb Box

New House 1

~~No Measurement~~

8' to MAIN

3/4" COPPER

OK [Signature]