


Labor and Materials

Copper } Connection	2	\$ 2.60
Lead } Connection	2	
Curb } Cock Valve	1	\$ 2.27
T.S. & V. }	1	
Service Box } Short 3 1/2 x 4 1/2	1	\$ 1.59
Old returned } Long 4 1/2 x 5 1/2	1	
	Buff. or Rdway	
22 Ft. in. } Copper Pipe at	3	\$ 3.96
	Cast Iron	
Nipples in. at		\$
Bushings to in. at		\$
Red'g } Couplings to in. at		\$
Inc'g }		
Union in. at		\$
Meter in. at		\$
Lbs. Br. Stone at		\$
Lbs. Sand at		\$
Bags Cement at		\$
Paving Brick } Mack		\$
	Red	
	Asphalt	
Lead Joints at		\$
Leadite Joints at		\$
3 Hrs. Foreman at		\$ 1.88
7 Hrs. Common Labor at		\$ 3.15
Hrs. Common Labor at		\$
Hrs. Mason at		\$
Hrs. Mason's Helper at		\$
Hrs. Compressor at		\$
Compensation Ins.		\$.15
Trucking		\$ 1.00
Builders' Use of Water	no Patch	\$
	Jewer	
Total		\$ 16.61

Labor and Material Report

19

231 Sheridan St.

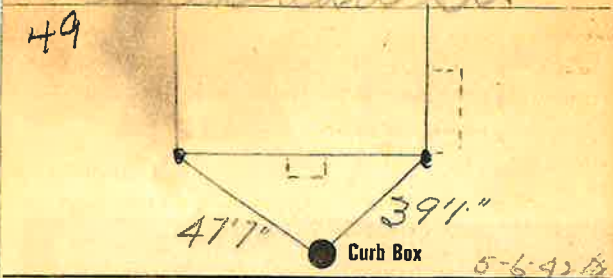

6 Main Eley of Main at tap 4

Gate at TAX ID # 302.19-4-12 Gate at

32' to main
 9 3/4 copper
 no measurements