


Labor and Materials

1	Copper	Connection	3/4"	96
1	Lead			
1	Curb	Cock Valve T.S.&V.	3/4" in	1.33
1	Service Box			
	Old returned	Short 3 1/2 x 4 1/2		1.35
		Long 4 1/2 x 5 1/2		
		<del>Butt or B&amp;W</del>		
5	Ft. 3/4" in.	Copper Galv. Iron Cast Iron	Pipe at 15	75
	Nipples			
	Bushings	to	in. at	
	Red'g Inc'g	Couplings	to	in. at
	Union			
	Meter	in. at		
	Lbs. Br. Stone	at		
	Lbs. Sand	at		
	Bags Cement	at		
	Paving Brick	Mack Red Asphalt	at	
	Lead Joints			
	Leadite Joints	at		
8	Hrs. Foreman	at 6.25		5.00
2	Hrs. Common Labor	at 6.25		1.25
12	Hrs. Common Labor	at 45		5.40
	Hrs. Mason	at		
	Hrs. Masons Helper	at		
	Hrs. Compressor	at		
	Compensation Ins			
	Trucking			1.00
	Builders Use of Water	marked B.P.		
	Total			\$

50 Sheridan St

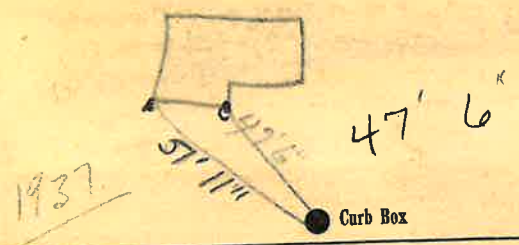

6 Main Elev. of Main at tap 4 1/2

Gate at TAX ID # 302.19-9-7 Gate at

● Curb Box

New House  
 5' to MAIN  
 3/4" copper