


**Labor and Materials**

9/19/31	Copper } Connection... 1	\$ 3.20
	Lead } .....	
	Curb } Cock } 1 in.	\$ 1.00
	} Valve } .....	
	} T. S. & V. } .....	
	Service Box } Short 3/4 x 4 1/2	\$ 1.20
	Old returned } Long 4 1/2 x 5 1/2	
	} Buff or Rdway } .....	
9	Ft. .... in. } Copper } Pipe at	\$ 1.98
	} Galv. Iron } .....	
	} Cast Iron } .....	
	Nipples..... in. at.....	\$
	Bushings..... to..... in. at.....	\$
	Red'g } Couplings..... to..... in. at.....	\$
	Inc'g } .....	
	Union..... in. at.....	\$
	Meter..... in. at.....	\$
	Lbs Br. Stone at.....	\$
	Lbs. Sand at.....	\$
	Bags Cement at.....	\$
	Paving Brick } Mack } at.....	\$
	} Red } .....	
	} Asphalt } .....	
	Lead Joints at.....	\$
	Leadite Joints at.....	\$
2	Hrs. Foreman at..... 62.5	\$ 1.25
2	Hrs Common Labor at..... 50	\$ 1.00
	Hrs. Common Labor at.....	\$
	Hrs. Mason at.....	\$
	Hrs Mason's Helper at.....	\$
	Hrs. Compressor at.....	\$
	Compensation Ins.....	\$ .07
	Trucking.....	\$ 1.00
	Builders' Use of Water.....	\$
	<b>Total</b> \$10.80	

**Labor and Material Report**

July 16 - 1931

Ex. S. Horrocks St

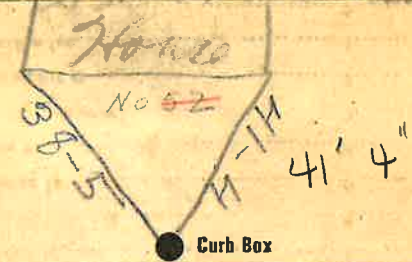

6 in Main

Elev. of Main at tap 4 1/2

Gate at ●

● Gate at

● Curb Box

New House

9' to main

3/4" copper