


LABOR AND MATERIALS

- 3/4 Copper Connection _____ \$ _____
- _____ Lead _____ \$ _____
- _____ Curb } Cock _____ in. _____ \$ _____
- _____ } Valve _____
- _____ } T.S. & V. _____
- _____ Service box { Short 3-1/2 x 4-1/2 } _____ \$ _____
- _____ Old returned { Long 4-1/2 x 5-1/2 } _____
- 27 Ft. _____ in. { Copper } Pipe at _____ \$ _____
- _____ } G.I. _____
- _____ } C.I. _____
- _____ Nipples _____ in. at _____ \$ _____
- _____ Bushings _____ to _____ in. at _____ \$ _____
- _____ Red'g _____
- _____ Inc'g _____
- _____ Union _____ in. at _____ \$ _____
- _____ Meter _____ in. at _____ \$ _____
- _____ \$ _____
- _____ Compound Joints at _____ \$ _____
- _____ Maintenance Foreman _____ \$ _____
- _____ Hrs. Water Maint. Man - 1 at _____ \$ _____
- _____ Hrs. Water Maint. Man - 2 at _____ \$ _____
- _____ Hrs. Garage Foreman _____ at _____ \$ _____
- _____ Hrs. Labor _____ at _____ \$ _____
- _____ Hrs. Compressor at _____ \$ _____
- _____ \$ _____
- _____ Trucking _____ \$ _____
- _____ Pav't Patch _____ \$ _____
- _____ \$ _____
- _____ \$ _____
Sheridan St. Pl. Ave. No. 8

Name of Owner _____

Labor and Mat'l. Report 19 _____

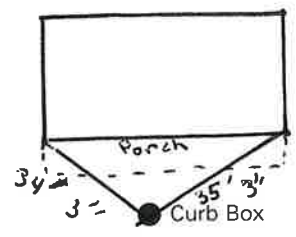

_____ Main Elev. of Main at tap _____

Gate at ● Gate at ●

TAX ID # 302.19-11-7.3

● Curb Box
Sum 20' of SAP 35