

LABOR AND MATERIALS


1	Copper	} Connection	3/4"	\$		
	Lead					
1	Curb	} Cock Valve T.S. & V.	3/4 in.	\$		
1	Service box	} Short 3 1/2 x 4 1/2 Long 4 1/2 x 5 1/2 Buff or Rdway		\$		
	Old returned					
24	Ft. 3/4 in.	} Copper G.I. G.I.	}	Pipe at	\$	
	Nipples	in.	at	\$		
	Bushings	to	in.	at	\$	
	Red'g	} Coupl'gs	to	in.	at	\$
	Inc'g					
	Union	in.	at	\$		
	Meter	in.	at	\$		
	Lead Joints	at	\$			
	Compound Joints	at	\$			
	Maintenance Foreman		\$			
	Hrs. Water Maint. Man-1	at	\$			
	Hrs. Water Maint. Man-2	at	\$			
	Hrs. Garage Foreman	at	\$			
	Hrs. Labor	at	\$			
	Hrs. Compressor	at	\$			
	Compensation Ins.	at \$	per C.	\$		
	Trucking		\$			
	Pav't Patch		\$			
	Tap by Gifford & Co.		\$			
			\$			
			\$			
	O'head		\$			
			\$			

2-27-69.

Sheridan St. Pt. Ave. No. 55

Name of Owner Spitzer

Labor and Mat'l. Report Feb. 27 1969.

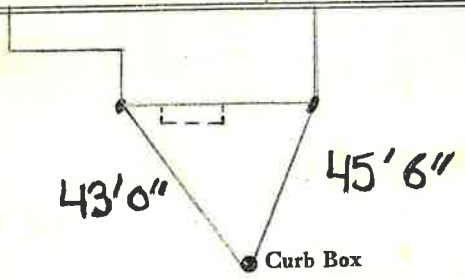

6 Main Elev. of Main at tap 4 1/2'

Gate at • Gate at • TAX ID# 302.19-4-10

• Curb Box
24' to main
3/4" copper