


### Labor and Materials

1	Copper } Connection $\frac{3}{4}$	\$
1	Curb { Cock Valve P. S. & V. } $\frac{3}{4}$ in.	\$
1	Service Box { Short 3' x 4' Old returned { Long 4' x 5' Buff. or Rdway } }	\$
8	Ft. in. { Copper Galv. Iron Cast Iron } Pipe at.	\$
	Nipples in. at.	\$
	Bushings to in. at.	\$
	Red'g } Couplings to in. at. Inc'g }	\$
	Union in. at.	\$
	Meter in. at.	\$
	Lbs. Br. Stone at.	\$
	Lbs. Sand at.	\$
	Bags Cement at.	\$
	Paving Brick { Mack Red Asphalt } at.	\$
	Lead Joints at.	\$
	Leadite Joints at.	\$
2	Hrs. Foreman at.	\$
1.2	Hrs. Common Labor at.	\$
	Hrs. Common Labor at.	\$
	Hrs. Mason at.	\$
	Hrs. Mason's Helper at.	\$
	Hrs. Compressor at.	\$
	Compensation Ins.	\$
	Trucking	\$
	Builders' Use of Water	\$
Total \$		\$

### Labor and Material Report

Dixon 18. 1927

$\frac{3}{4}$  Tap <sup>56</sup> Shunday St

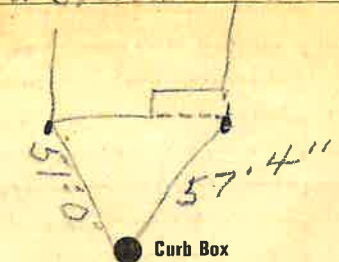

6 Main Elev. of  
Main at tap

---

Gate at ● TAX ID # 302.19-9-9 ● Gate at

● Curb Box

8' to MAIN  
 $\frac{3}{4}$ " COPPER