

LABOR AND MATERIALS

1	Copper Lead	Connection	3/4"		\$ 1.23
1	Curb	Cock Valve T. S. & V.	3/4 in.		\$ 1.68
1	Service Box Old returned	Short 3 1/2 x 4 1/2 Long 4 1/2 x 5 1/2 Buff. or Rdway			\$ 1.54
23	Ft.	3/4 in.		Copper Galv Iron Cast Iron	Pipe at 17 \$ 3.91
	Nipples	in. at			\$
	Bushings	to in. at			\$
	Red'g Inc'g	Couplings	to in. at		\$
	Union	in. at			\$
	Meter	in. at			\$
	Lead Joints	at			\$
	Leadite Joints	at			\$
	Hrs. Foreman	at			\$
2	Hrs. Chauffeur	at	6 1/2 hr		\$ 1.25
4	Hrs. Tapper	at	"		\$ 2.50
8	Hrs. Labor	at	45		\$ 3.60
	Hrs. Labor	at			\$
	Hrs. Compressor	at			\$
	Compensation Ins.				\$.23
	Trucking				\$ 1-
	Builders Use of Water				\$
	Tapping Hauled				\$
	Patch - 1/2 Sewer Dept				\$ 2.50
					\$
					\$ 19.44

46 -- 1939

St.

Pt.

Sheridan

Ave. No. 61


Name of Owner

Hutchinson

Labor and Mat'l. Report

July 17

1939

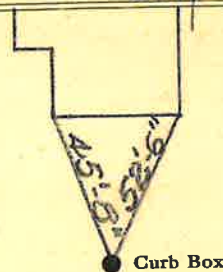

6" Main

Elev. of
Main at tap 5'

Gate at ●

● Gate at

TAX ID # 302.19-3-19

● Curb Box

New House
23' to MAIN
3/4" copper