


St. Pl. Ave. No. 62
Sheridan
Name of Owner

Labor and Mat'l. Report May 27 renewal tap 1982

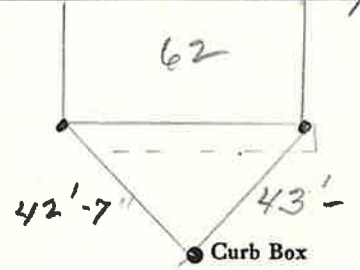


Main Elev. of Main at tap
Gate at • Gate at

TAX ID # 302.19-8-1

• Curb Box
7' to main
3/4\"/>

Labor and Material Report May 21 1984

3/4\"/>

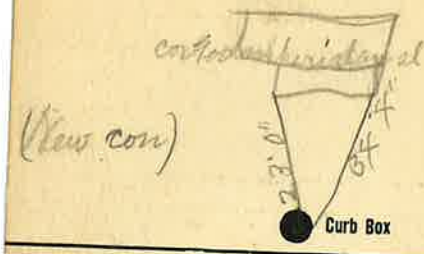

6' Main Elev. of Main at tap 4 1/2
Gate at • Gate at

• Curb Box

LABOR AND MATERIALS

Copper	} Connection		\$	
Lead				
Curb	} Cock Valve } in.		\$	
		T. S. & V.		
Service box		} Short 3½ x 4½ Long 4½ x 5½ Buff or Rdway }		\$
Old returned				
7 Ft. ³ / ₄ in.	} Copper G. I. C. I. }	Pipe at	\$	
Nipples		in. at	\$	
Bushings		to in. at	\$	
Red'g } Inc'g }	} Coupl'gs	to in. at	\$	
Union		in. at	\$	
Meter	in. at	\$		
Lead Joints at		\$		
Compound Joints at		\$		
Maintenance Foreman		\$		
Hrs. Water Maint. Man—1 at		\$		
Hrs. Water Maint. Man—2 at		\$		
Hrs. Garage Foreman at		\$		
Hrs. Labor— at		\$		
Hrs. Compressor at		\$		
Compensation Ins. at \$ _____ per C		\$		
Trucking		\$		
Pav't Patch		\$		
		\$		
		\$		
O'head		\$		
		\$		

Labor and Materials R

Lead Connection		\$
Curb Cock		\$
Service Box	(Short 3½ x 4½ Long 4½ x 5½ Buffalo	\$
Old returned		
7 Ft. ³ / ₄ in. G. I. Pipe at		\$
Nipples	in. at	\$
Bushings	to in. at	\$
Red'g Coup	to in. at	\$
Inc'g Coup	to in. at	\$
Union	in. at	\$
Meter	in. at	\$
Cu. Yds. Br. Stone at		\$
Cu. Yds. Sand at		\$
Bags Cement at		\$
Paving Brick	(Mack Red Asphalt)	at \$
Hrs. Foreman at		\$
Hrs. Common Labor at		\$
Hrs. Mason at		\$
Hrs.	at	\$
Hrs.	at	\$
Builders' Use of Water		\$
		\$
TRUCKING		\$
		\$
		\$
Total		\$ 10.39