


St. Pl. Ave. No. 62  
Sheridan  
Name of Owner

Labor and Mat'l. Report May 27 renewal tap 1952

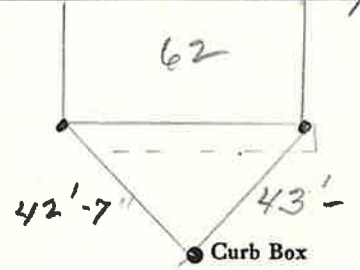


Main Elev. of Main at tap  
Gate at • Gate at

TAX ID # 302.19-8-1

• Curb Box  
7' to main  
3/4\"/>

Labor and Material Report May 21 1954

3/4\"/>

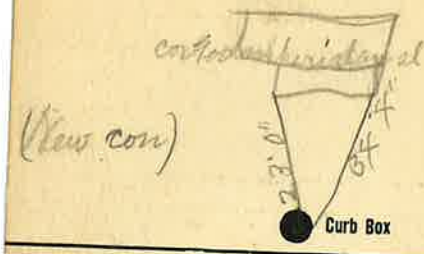

6 Main Elev. of Main at tap 4 1/2  
Gate at • Gate at

• Curb Box

LABOR AND MATERIALS

Copper	} Connection		\$	
Lead				
Curb	} Cock Valve T. S. & V.	in.	\$	
Service box		} Short 3½ x 4½ Long 4½ x 5½ Buff or Rdway		\$
Old returned				\$
7 Ft. ¾ in.	} Copper G. I. C. I.	Pipe at	\$	
Nipples		in. at	\$	
Bushings		to in. at	\$	
Red'g	} Coupl'gs	to in. at	\$	
Inc'g			\$	
Union	in. at	\$		
Meter	in. at	\$		
Lead Joints at		\$		
Compound Joints at		\$		
Maintenance Foreman		\$		
Hrs. Water Maint. Man—1 at		\$		
Hrs. Water Maint. Man—2 at		\$		
Hrs. Garage Foreman at		\$		
Hrs. Labor— at		\$		
Hrs. Compressor at		\$		
Compensation Ins. at \$ per C		\$		
Trucking		\$		
Pav't Patch		\$		
		\$		
		\$		
O'head		\$		
		\$		

Labor and Materials R

Lead Connection	\$
Curb Cock	\$
Service Box (Short 3½ x 4½ Old returned (Long 4½ x 5½ Buffalo)	\$
7 Ft. in. G. I. Pipe at	\$
Nipples in. at	\$
Bushings to in. at	\$
Red'g Coup. to in. at	\$
Inc'g Coup. to in. at	\$
Union in. at	\$
Meter in. at	\$
Cu. Yds. Br. Stone at	\$
Cu. Yds. Sand at	\$
Bags Cement at	\$
Paving Brick (Mack Red Asphalt) at	\$
Hrs. Foreman at	\$
Hrs. Common Labor at	\$
Hrs. Mason at	\$
Hrs. at	\$
Hrs. at	\$
Builders' Use of Water	\$
Trucking	\$
	\$
	\$
Total	\$ 10.39