

LABOR AND MATERIALS

1	Copper	Connection	3/4"	\$	304
1	Lead			\$	
1	Curb	Cock Valve T.S. & V.	3/4 in.	\$	3.54
1	Service box	Short 3 1/2 x 4 1/2		\$	4.70
	Old returned	Long 4 1/2 x 5 1/2		\$	
22	Ft. 3/4 in.	Buff. or Rdway		\$	
		Copper	Pipe at 35	\$	7.70
		G.I.		\$	
		C.I.		\$	
	Nipples	in. at		\$	
	Bushings	to in. at		\$	
	Red'g	Coupl'gs to in. at		\$	
	Inc'g			\$	
	Union	in. at		\$	
	Meter	in. at		\$	
	Lead Joints at			\$	
	Compound Joints at			\$	
1	Hrs. Water Maint. Man-1	at		\$	1.23
7	Hrs. Water Maint. Man-2	at 1.13		\$	7.91
12	Hrs. Labor	at 1.02		\$	12.24
	Hrs. Labor	at		\$	
3	Hrs. Compressor at	1.50		\$	4.50
	Compensation Ins. at \$		per C.	\$	5.7
	Trucking			\$	1.00
	Pav't Patch			\$	16.20
				\$	
				\$	
	O'head			\$	
				\$	62.63


Tap made by Warsinski
Sept 24 1951

Sheridan

St. Pl. Ave. No. 67

Name of Owner
Anthony Tonis

Labor and Mat'l. Report
Sept 24 1951

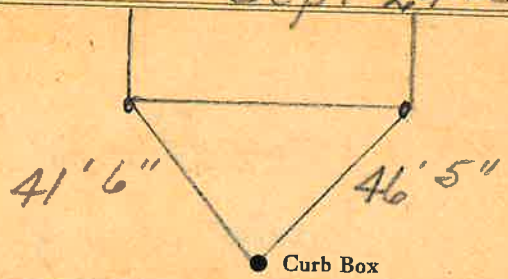

6" Main
Elev. of Main at tap 5'

TAX ID # 302.19-3-18

22' to MAIN
3/4" copper