


Labor and Materials

Copper } Connection.....	\$.....
Lead }	\$.....
Curb { Cock }	\$.....
{ Valve }	\$.....
{ T. S. & V. }	\$.....
Service Box { Short 3½ x 4½ }	\$.....
Old returned { Long 4½ x 5½ }	\$.....
{ Buff. or Rdway }	\$.....
Ft. in. { Copper } Pipe at.....	\$.....
{ Galv. Iron }	\$.....
{ Cast Iron }	\$.....
Nipples..... in. at.....	\$.....
Bushings..... to..... in. at.....	\$.....
Red'g } Couplings..... to..... in. at.....	\$.....
Inc'g }	\$.....
Union..... in. at.....	\$.....
Meter..... in. at.....	\$.....
Lbs. Br. Stone at.....	\$.....
Lbs. Sand at.....	\$.....
Bags Cement at.....	\$.....
Paving Brick { Mack } at.....	\$.....
{ Red }	\$.....
{ Asphalt }	\$.....
Lead Joints at.....	\$.....
Leadite Joints at.....	\$.....
Hrs. Foreman at.....	\$.....
Hrs. Common Labor at.....	\$.....
Hrs. Common Labor at.....	\$.....
Hrs. Mason at.....	\$.....
Hrs. Mason's Helper at.....	\$.....
Hrs. Compressor at.....	\$.....
Compensation Ins.....	\$.....
Trucking.....	\$.....
Builders' Use of Water.....	\$.....
Total \$.....	

Labor and Material Report : June 1929

69 Sheridan

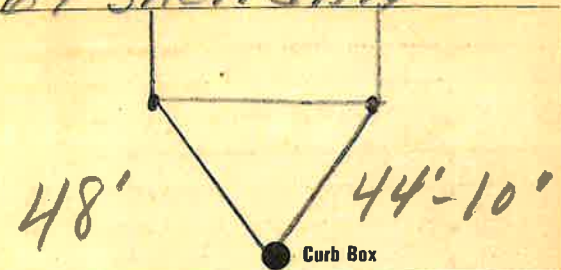

TAX ID # 302.19-3-17

6 Main Elev. of Main at tap

Gate at ● ● Gate at

● Curb Box