


LABOR AND MATERIALS

Copper	} Connection	_____	\$ _____		
Lead					
Curb	} Cock Valve	_____ in.	\$ _____		
				} T. S. & V.	
Service box	} Short 3 1/2 x 4 1/2	_____	\$ _____		
Old returned				} Long 4 1/2 x 5 1/2	
					} Buff or Rdway
9' Ft.	} Copper G.I.	_____ in.	\$ _____		
Nipples	_____ in.	at _____	\$ _____		
Bushings	_____ to _____	in. at _____	\$ _____		
Red'g	} Coupl'gs	_____ to _____	in. at _____		
Inc'g					
Union	_____ in.	at _____	\$ _____		
Meter	_____ in.	at _____	\$ _____		
Lead Joints	at _____		\$ _____		
Compound Joints	at _____		\$ _____		
Maintenance Foreman	_____		\$ _____		
Hrs. Water Maint. Man—1	at _____		\$ _____		
Hrs. Water Maint. Man—2	at _____		\$ _____		
Hrs. Garage Foreman	_____ at _____		\$ _____		
Hrs. Labor—	_____ at _____		\$ _____		
Hrs. Compressor	at _____		\$ _____		
Compensation Ins.	at \$ _____ per C		\$ _____		
Trucking	_____		\$ _____		
Pav't Patch	_____		\$ _____		
			\$ _____		
			\$ _____		
			\$ _____		
O'head	_____		\$ _____		
			\$ _____		

SHERDIAN St. Pl. Ave. No. 9

Name of Owner _____

Labor and Mat'l. Report 19 78

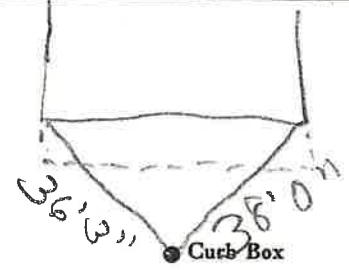

6 Main Elev. of Main at tap 5 1/2

Gate at • Gate at •

TAX ID# 302.15-13-16

9' to main • Curb Box